


421 E. Elm Street, Lansing, MI. | As-Builts


Integrated Architecture

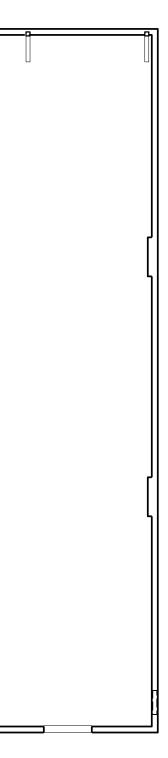

19 April 2016

WolverineDevelopment.com

20160310

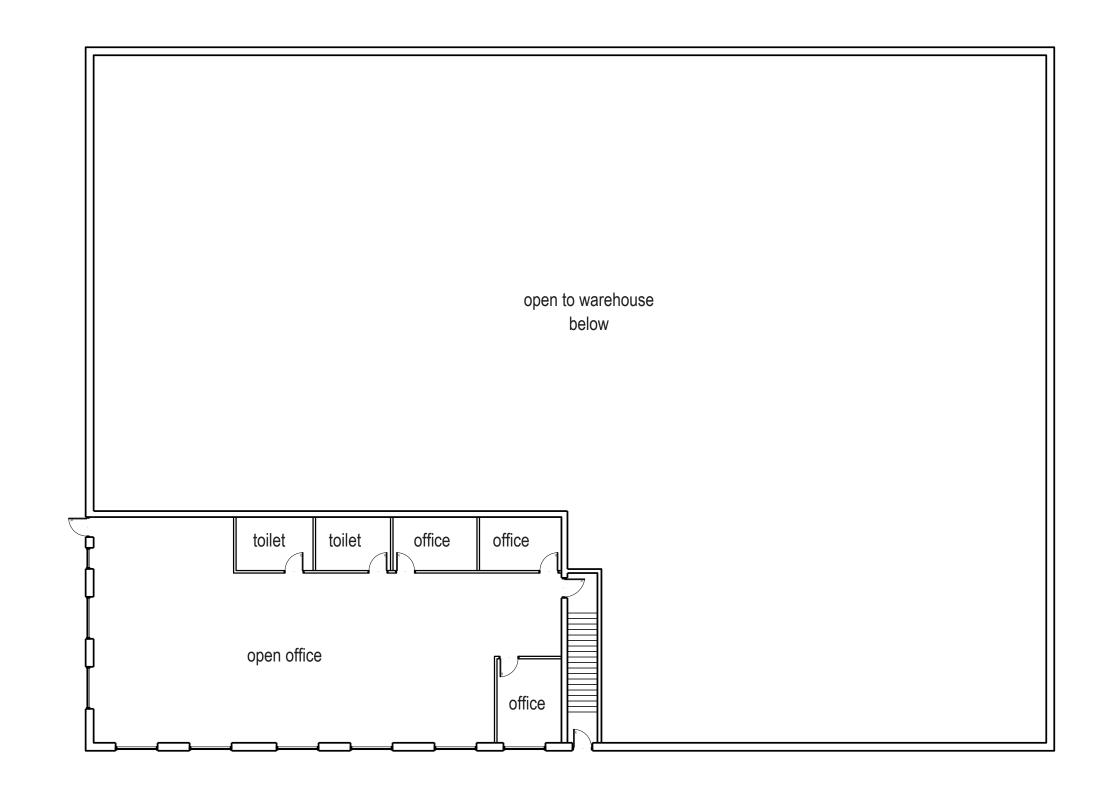

scale

16'

0'

θN

32'

Second Floor

3,380 gsf



421 E. Elm Street, Lansing, MI. | As-Builts

© 2016 Integrated Architecture AI rights reserved No part of this document may be used or reproduced in any form or by any means, or stored in a database or retrieval system, without the prior written permission of Integrated Architectur

19 April 2016

WolverineDevelopment.com

20160310